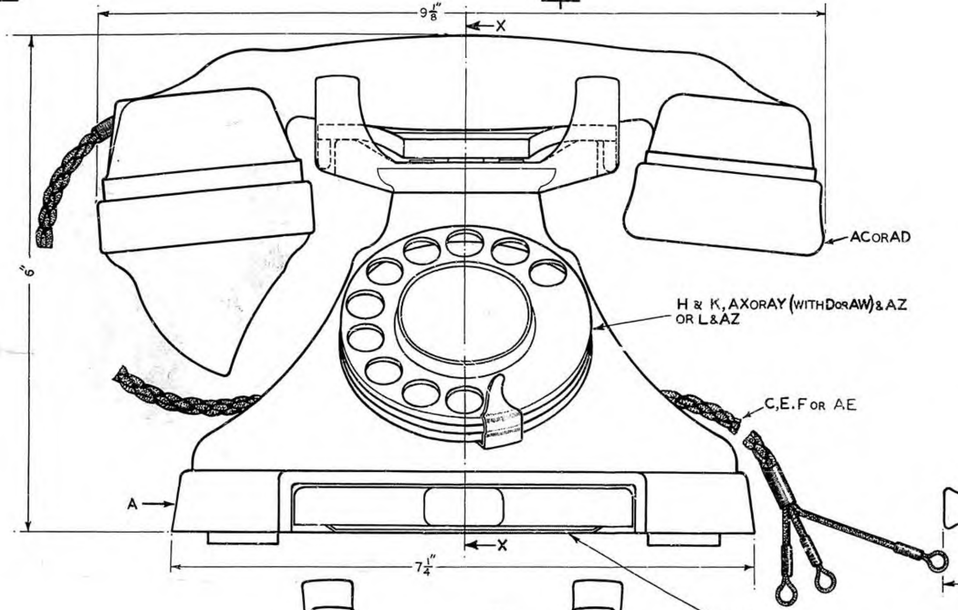

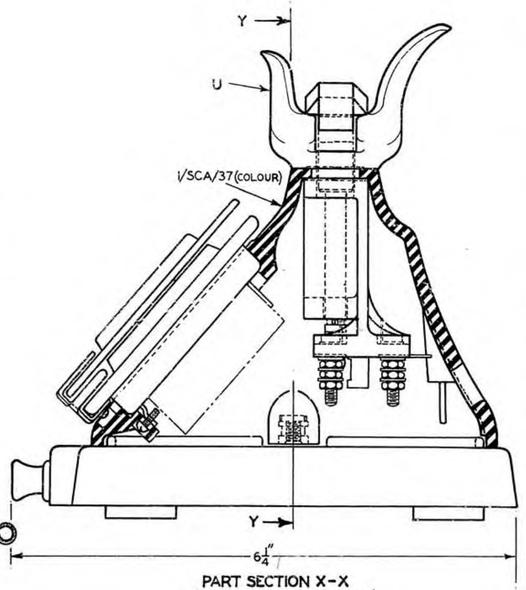

PART SECTION X-X
(ITEM AC OR AD OMITTED)

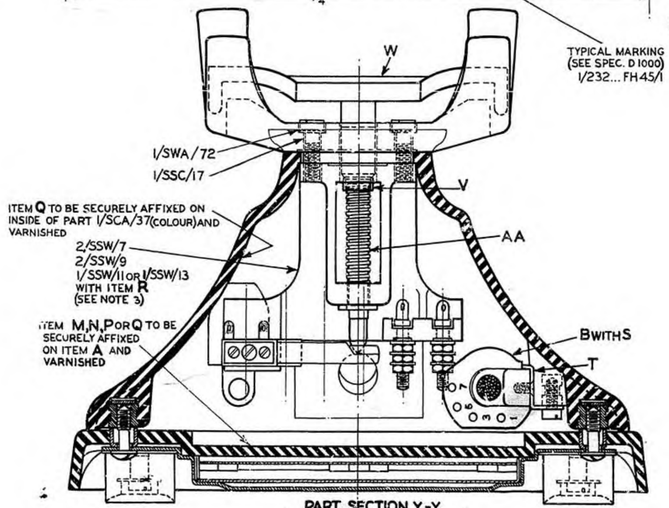

PART SECTION Y-Y
(ITEM AC OR AD OMITTED)

NOTES:—

1. OVERALL DIMENSIONS APPROX. ONLY.
2. ITEMS S & T EACH TO BE SUPPLIED WITH 1 SC. 5 BA. x 1/4" CH. HD., BR., Ni.P.
3. ITEM R FITTED BETWEEN TERMINALS 3 & 4 OF PARTS 2/SSW/7, 2/SSW/9, 1/SSW/11 & 1/SSW/13
4. FOR METHOD OF FIXING ITEMS AB, AF, AG & DETAILS 1 TO 5 & MOD. OF PART 1/SCA/37(COLOUR) SEE DRG. 60,267
5. PART 1/SCA/62 TO BE RECOVERED AND PART 2/SCA/52 FITTED.

GAUGE FOR PARTS :-
2/SSW/7
2/SSW/9
1/SSW/11
1/SSW/13
1/SCR/1
} SEE DRG. 63778

SCHEDULE

ITEM	DESCRIPTION	QUANTITY TELEPHONE No. 1/226 CB (COLOUR)	1/232 B (COLOUR)	1/232 CB (COLOUR)	1/232 F (COLOUR)	1/232 L (COLOUR)	1/232 S (COLOUR)	1/240 BLACK	248 CB BLACK, MINUS BASE MK 1	248 CB BLACK, MINUS BASE MK 2	DRG. OR DGM.
A	BASE, TELEPHONE No. 1/162 (COLOUR)	1	1	1	1	1	1	1	—	—	—
B	COIL, INDUCTION No. 27	1	1	1	1	1	1	1	1	1	62,207
C	CORD INST. No. 3/62B (COLOUR) 54"	—	1	1	1	1	1	—	—	—	62,149
D	" " " 5/09E 3"	—	—	—	1	1	1	—	—	—	62,240
E	" " " 6/31E 8"	—	1	—	—	—	1	—	—	—	62,117
F	" " " 9/10H (COLOUR) 54"	1	—	—	—	—	1	—	—	—	62,277
~~G~~	~~DIAL AUTO. SS No. 10 BA~~	~~—~~	~~—~~	~~—~~	~~—~~	~~—~~	~~—~~	~~—~~	~~—~~	~~—~~	~~62,880~~
H	DIAL AUTO. SS No. 10 FA	—	—	—	1	—	—	—	—	—	"
~~J~~	~~" " " 10 FS~~	~~—~~	~~—~~	~~—~~	~~—~~	~~—~~	~~—~~	~~—~~	~~—~~	~~—~~	~~"~~
K	DIAL AUTO. SS No. 10 LA	—	—	—	1	—	—	—	—	—	"
L	" " DUMMY No. 3 (COLOUR)	1	—	1	—	—	—	1	1	1	62,952
M	LABEL DIAGRAM N 326	1	—	—	—	—	—	—	—	—	DGM. N 326
N	" " N 332	—	1	1	1	1	—	1	—	—	DGM. N 332
P	" " N 340	—	—	—	—	—	—	1	—	—	DGM. N 340
Q	" " N 348	—	—	—	—	—	—	—	—	1	DGM. N 348 PANEL P2
R	LINK, BRASS No. 6 (SEE NOTE 3)	1	—	1	—	—	—	1	1	1	62,689
S	PART No. 1/SBR/3 (SEE NOTE 2)	1	—	1	1	1	1	1	1	1	SBR/3
T	" " 1/SBR/4 "	1	—	1	1	1	1	1	1	1	SBR/4
U	" " 1/SCR/1 (COLOUR)	1	—	1	1	1	1	1	1	1	SCR/1
V	" " 2/SCU/1	1	1	1	1	1	1	1	1	1	SCU/1
W	" " 1/SPL/321 (COLOUR)	1	1	1	1	1	1	1	1	1	SPL/321
AA	" " 3/SSP/513	1	1	1	1	1	1	1	1	1	SSP/513
AB	POTENTIOMETER No. 9A (SEE NOTE 4)	1	—	—	—	—	—	—	—	—	CD 426
AC	TELEPHONE No. 164 (COLOUR)	—	1	1	1	1	1	1	1	1	9,509/0
AD	" " 184 (COLOUR)	1	—	—	—	—	—	—	—	—	9,808/0
AE	CORD INST. No. 8/10 E 8"	—	—	—	—	—	—	—	—	—	63,078
AF	WASHER, LOCKING No. 1220 (SEE NOTE 4)	1	—	—	—	—	—	—	—	—	C D 338
AG	KNOB, INST. No. 5A (COLOUR) (SEE NOTE 4)	1	—	—	—	—	—	—	—	—	CD 456
1/SCA/37 (COLOUR)		SEE NOTE 4	1	1	1	1	1	1	1	1	SCA/37
1/SSC/17		2	2	2	2	2	2	2	2	2	SSC/17
2/SSW/7		1	—	—	—	—	—	—	—	—	SSW/7
2/SSW/9		—	1	1	1	1	1	—	1	1	SSW/9
1/SSW/11		—	—	—	—	—	—	1	—	—	SSW/11
1/SSW/13		—	—	—	—	—	—	1	—	—	SSW/13
1/SWA/72		2	2	2	2	2	2	2	2	2	SWA/72
1 TO 5	(SEE NOTE 4)	1 OFF EACH	—	—	—	—	—	—	—	—	60,267
REQUISITIONED SEPARATELY AS REQUIRED AND FITTED LOCALLY											
AW	CORD INST. No. 5/09E 3"	1	—	—	—	—	—	—	1	1	62,240
AX	DIAL AUTO. SS. No. 10	1	—	—	—	—	—	—	1	1	62,888
AY	DIAL AUTO. SS. No. 11 MOD (SEE NOTE 5)	—	—	—	—	—	—	1	—	—	62,888
AZ	LABEL No. 160...	1	1	1	1	1	1	1	1	1	61,034
SPECS		S 156	S 93	S 93	S 93	S 93	S 93	—	S 164	S 164	

COLOURS:— BLACK, RED, IVORY & GREEN.

BRITISH TELECOMMUNICATIONS
FACTORIES DIV. HQ.

File Ref. S/1000/... (TELE. No.) Date 3-2-37

Drn. T.C.W. Tcd. T.C.W. Ckd. C.P Appd. in F.1.7.4.2

ORIGINAL SIGNED BY
F. REID. 17.8.

SUPERSEDED FOR NEW WORK BY DRG. 62828/1 TELE. No. 1/232... SUPERSEDES FOR NEW WORK TELE. No. 1/162...

Amendment	Suffix
TELE. No. 1/248 CB ADDED. H.K. A2/1677 H.C. C.R. 15-12-37	B
REDRAWN. TELE. No. 1/232 W DELETED. TELE No. 248 CB BLACK, MINUS BASE WAS INCORRECTLY SHOWN AS TELE. No. 1/248 CB. TELE. No. 1/240 BLACK:- PART 2/12,977 DELETED & PART 1/SSW/13 ADDED. ITEM B WAS COIL, INDUCTION No. 24. ITEMS D & E WERE INCORRECTLY SHOWN AS BROWN. TYPICAL MARKING AMENDED. PART 1/SWA/72, ITEMS AW TO AZ, NOTES 2 TO 5 & COLOURS ADDED. DIMS. 9 1/8" & 6 1/4" WERE SHOWN AS 9 & 5 RESPECTIVELY. SUPERSESSION NOTE ADDED. A.P.H. 10-10-43	C
SCHEDULE:- TELE. No. 248 CB. MARK 2, ADDED. 19-9-45	D
A & SUPERSESSION NOTE RE DRG 62,828/1, ITEMS AF & AG ADDED. 10.2.47	E
DRG. No. OF ITEM AA WAS INCORRECTLY SHOWN AS SEP/531 5.6.47	F
ITEMS G & J, TELES. Nos. 1/232 B & 1/232 S DELETED. CHINESE & JADE DELETED FROM COLOURS. RED & GREEN, 30-10-56	G
TITLE OF SECTION	H

GENERAL DISTRIBUTION

SEE SCHED. | SEE SCHED. | D 1000

Drgs. | Dgms | Specs.

TELEPHONES Nos. 1/226 CB (COLOUR), 1/232... (COLOUR), 1/240 BLACK (MARK 1)

Scale:— 1/1 | Wiring Dgm. SEE SCHEDULE | Assembly Drg —

Spec S.77 AND SEE SCHED.

DRG. 62,828/0